LABOR AND MATERIALS

1 Copper ~~Lead~~ Connection 3/4"		$ 2.71
1 Curb { ~~Cock~~ ~~Valve~~ ~~T.S. & V.~~ } 3/4 in.		$ 3.83
1 Service box { ~~Short 3½ x 4½~~ ~~Long 4½ x 5½~~ ~~Buff or Rdway~~ }		$ 4.69
20 Ft. 3/4 in. { ~~Copper~~ ~~G. I.~~ ~~C. I.~~ } Pipe at 45		$ 9.00
Nipples in. at		$
Bushings to in. at		$
Red'g Inc'g Coupl'gs to in. at		$
Union in. at		$
Meter in. at		$
Lead Joints at		$
Compound Joints at		$
2 Maintenance Foreman 1.51		$ 3.02
Hrs. Water Maint. Man—1 at		$
10 Hrs. Water Maint. Man—2 at 1.24		$ 12.40
Hrs. Garage Foreman at		$
20 Hrs. Labor— at 1.13		$ 22.60
Hrs. Compressor at		$
Compensation Ins. at $ 4.29 per C		$ 1.63
Trucking		$ 1.56
Pav't Patch		$ 18.00
Tap by Gifford & Co. 6-8-55		$
		$
		$
O'head		$
		$ 79.38

61.38

St. Pl. Ave. No. 32

Mason

Name of Owner

M. Davison.

Labor and Mat'l. Report June 8 1955

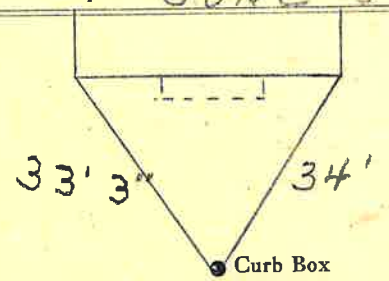

4" Main

Elev. of Main at tap 5'

Gate at •

• Gate at

• Curb Box

Tax ID # 302.12-16-22

L. M—5C—2-1-54