62-147

St.
~~Pl.~~
~~Ave.~~ No. 34

Mason

Name of Owner

Emmett L. George

Labor and Mat'l. Report of July 25 19 47

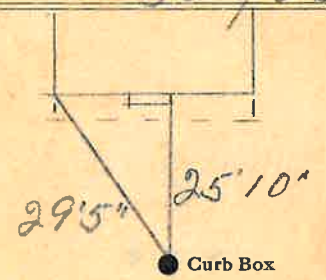

4 Main

Elev. of Main at tap 4'

Gate at ● ● Gate at

● Curb Box

Tax ID # 302.12-16.23

LSM-5C-6-1-45

LABOR AND MATERIALS

1	Copper Lead } Connection 3/4	$ 2.80
1	Curb { Clock Valve T. S. & V. } 3/4 in.	$ 3.60
1	Service box Old returned { Short 3½X4½ ~~Long 4½X5½~~ ~~Buff or Rdway~~ }	$ 5.80
18	Ft. 3/4 in. { Copper ~~Galv. Iron~~ ~~Cast Iron~~ } Pipe at 35'	$ 6.30
	Nipples in. at	$
	Bushings to in. at	$
	Red'g Inc'g } Couplings to in. at	$
	Union in. at	$
	Meter in. at	$
	Lead Joints at	$
	Compound Joints at	$
2	Hrs. Foreman at	$ 2.02
2	Hrs. Chauffeur at	$ 1.82
	Hrs. Tapper at	$
15	Hrs. Labor at	$ 12.00
	Hrs. Labor at	$
	Hrs. Compressor at	$
	Compensation Ins.	$ .35
	Trucking	$ 1.—
	Builders Use of Water	$ —
	Tap by Mains Insp.	$
		$
		$
		$
		$ 35.69