LABOR AND MATERIALS

1	Copper ~~Lead~~ Connection 3/4	$ 1.35
1	Curb { Cock / Valve / T. S. & V. } 3/4 in.	$ 1.88
1	Service Box Old returned { Short 3½x4½ / Long 4½x5½ / Buff. or Rdway } Same	$ —
20 Ft. 3/4 in.	{ Copper / ~~Galv Iron~~ / ~~Cast Iron~~ } Pipe at 20	$ 4.00
	Nipples ____ in. at	$
	Bushings ____ to ____ in. at	$
	Red'g / Inc'g Couplings ____ to ____ in. at	$
	Union ____ in. at	$
	Meter ____ in. at	$
	Lead Joints at	$
	Leadite Joints at	$
	Hrs. Foreman at	$
6	Hrs. Chauffeur at 68¾	$ 4.12
6	Hrs. Tapper at "	$ 4.13
	Hrs. Labor at	$
	Hrs. Labor at	$
1	Hrs. Compressor at 97	$ .97
	Compensation Ins.	$ .26
	Trucking	$ 1.—
	Builders Use of Water Patch	$ .5.—
	Tap by Hesse/	$
		$
		$
		$
		$ 22.66

H.

2 1942

St. 387-13
~~Pl.~~
Mason Ave. No. 34

Name of Owner
Tich

Labor and Mat'l. Report May 27 194?

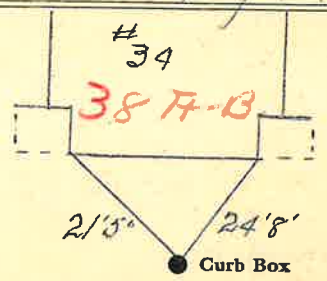

4" Main — Elev. of Main at tap 5

Gate at ● ● Gate at

● Curb Box

#38
Tax Map # 302.12-16.25

H.