LABOR AND MATERIALS

1	Copper Lead — Connection	3/4	$ 2.80
1	Curb — Clock Valve ~~T. S. & V.~~	3/4 in.	$ 3.60
1	Service box Old returned — ~~Short 3½X4½~~ ~~Long 4½X5½~~ Buff or Rdway		$ 5.80
20	Ft. 3/4 in. — Copper ~~Galv. Iron~~ ~~Cast Iron~~ Pipe at		$ 7.00
	Nipples ... in. at		$
	Bushings ... to ... in. at		$
	Red'g Inc'g — Couplings ... to ... in. at		$
	Union ... in. at		$
	Meter ... in. at		$
	Lead Joints at		$
	Compound Joints at		$
2	Hrs. Foreman at		$ 2.02
2	Hrs. Chauffeur at		$ 1.82
	Hrs. Tapper at		$
15	Hrs. Labor at		$ 12.00
	Hrs. Labor at		$
	Hrs. Compressor at		$
	Compensation Ins.		$ .35
	Trucking		$ 1.00
	Builders Use of Water		$ —
	Tap by Miller		$
			$
			$
			$
			$ 36.34

68 / 47

St. ~~Pl.~~ Aver No. 42

Mason

Name of Owner

Willard

Labor and Mat'l. Report July 29 1947

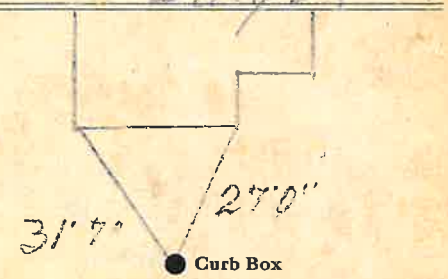

4 Main — Elev. of Main at tap 4'

Gate at ● — ● Gate at

● Curb Box

Tax Map # 302.12-16-27

LSM-5C-6-1-45