LABOR AND MATERIALS

1	Copper Lead } Connection	3/4	$ 2.80
1	Curb { Clock Valve T. S. & V. }	3/4 in.	$ 3.60
1	Service box Old returned { Short 3½X4½ Long 4½X5½ Buff or Rdway }		$ 5.80
18	Ft. 3/4 in. { Copper Galv. Iron Cast Iron } Pipe at		$ 6.30
	Nipples in. at		$
	Bushings to in. at		$
	Red'g Inc'g } Couplings to in. at		$
	Union in. at		$
	Meter in. at		$
	Lead Joints at		$
	Compound Joints at		$
2	Hrs. Foreman at		$ 2.02
2	Hrs. Chauffeur at		$ 1.82
	Hrs. Tapper at		$
15	Hrs. Labor at		$ 12.00
	Hrs. Labor at		$
	Hrs. Compressor at		$
	Compensation Ins.		$ 1.35
	Trucking		$ 1.00
	Builders Use of Water.		$
	Tap by Worcester		$
			$
			$
			$
			$ 35.69

6C 47

St. Pl. Ave. No. 41 Mason

Name of Owner

Rockwell

Labor and Mat'l. Report July 23 1917

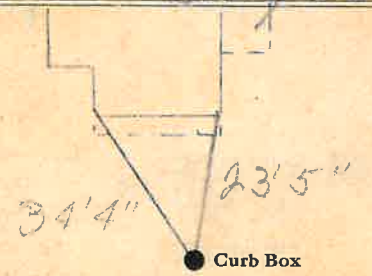

1 Main

Elev. of Main at tap 4½

Gate at ● ● Gate at

● Curb Box

Tax Map # 302. 12-16-28

LSM-5C-6-1-45