LABOR AND MATERIALS

1	Copper ~~Lead~~ Connection 3/4	$ 2.80
1	Curb { Clock Valve ~~T. S. & V.~~ } { 3/4 in.	$ 3.60
1	Service box Old returned { Short 3½X4½ ~~Long 4½X5½~~ ~~Buff or Rdway~~ }	$ 5.80
19	Ft. 3/4 in. { Copper ~~Galv. Iron~~ ~~Cast Iron~~ } Pipe at	$ 6.65
	...Nipples ... in. at	$
	...Bushings ... to ... in. at	$
	Red'g Inc'g } Couplings ... to ... in. at	$
	...Union ... in. at	$
	...Meter ... in. at	$
	...Lead Joints at	$
	...Compound Joints at	$ 2.02
2	...Hrs. Foreman at	$ 1.82
2	...Hrs. Chauffeur at	$
1	...Hrs. Tapper at	$ 12.00
15	...Hrs. Labor at	$
	...Hrs. Labor at	$
	...Hrs. Compressor at	$ .35
	...Compensation Ins.	$ 1.00
	...Trucking	$
	...Builders Use of Water	$
	Tap by Warsinske	$
		$
		$
		$ 36.04

73 J 17

St. ~~Pl.~~ ~~Ave.~~ No. 48

Mason

Name of Owner

Swan

Labor and Mat'l. Report July 24 1947

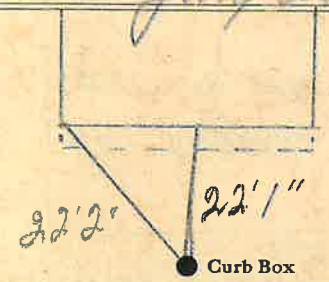

4 Main

Elev. of Main at tap 1½

Gate at ● ● Gate at

● Curb Box

Tax Map # 302.12-16.30

LSM-5C-6-1-45