LABOR AND MATERIALS

1	Copper ~~Lead~~ Connection 3/4		$ 2.80
1	Curb Clock ~~Valve~~ ~~T. S. & V.~~ 3/4 in.		$ 3.60
1	Service box Old returned	Short 3½X4½ ~~Long 4½X5½~~ ~~Buff or Rdway~~	$ 5.80
20 ~~18~~	Ft. 3/4 in.	Copper ~~Galv. Iron~~ ~~Cast Iron~~ Pipe at	$ 6.30
	Nipples in. at		$
	Bushings to in. at		$
	Red'g Inc'g Couplings to in. at		$
	Union in. at		$
	Meter in. at		$
	Lead Joints at		$
	Compound Joints at		$
2	Hrs. Foreman at		$ 2.02
2	Hrs. Chauffeur at		$ 1.82
	Hrs. Tapper at		$
15	Hrs. Labor at		$ 12.00
	Hrs. Labor at		$
	Hrs. Compressor at		$
	Compensation Ins.		$ .35
	Trucking		$ 1.—
	Builders Use of Water		$
	Tap by Warsinkle		$
			$
			$
			$
			$ 35.69

56-47

Mason St. ~~Pl.~~ Ave. No. 50

Name of Owner

F E Chase

Labor and Mat'l. Report July 25 1947

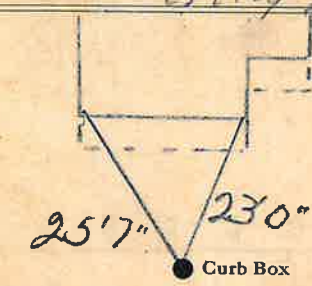

6"-1970

~~4~~ Main

Elev. of Main at tap 4½

Gate at ● ● Gate at

● Curb Box

Tax Map # 302.12-16-31

LSM-5C-6-1-45