LABOR AND MATERIALS

1	Copper ~~Lead~~ Connection 3/4		$ 2.80
1	Curb Clock ~~Valve~~ ~~T. S. & V.~~ 3/4 in.		$ 3.60
1	Service box Old returned Short 3½X4½ ~~Long 4½X5½~~ ~~Buff or Rdway~~		$ 5.80
5'6" ~~7~~	Ft. 3/4 in. Copper ~~Galv. Iron~~ ~~Cast Iron~~	Pipe at 35	$ 2.45
	Nipples in. at		$
	Bushings to in. at		$
	Red'g Inc'g Couplings to in. at		$
	Union in. at		$
	Meter in. at		$
	Lead Joints at		$
	Compound Joints at		$
2	Hrs. Foreman at		$ 2.02
1	Hrs. Chauffeur at		$ .91
	Hrs. Tapper at		$
13	Hrs. Labor at		$ 10.40
	Hrs. Labor at		$
	Hrs. Compressor at		$
	Compensation Ins.		$ .29
	Trucking		$ 1.—
	Builders Use of Water		$ —
	Taply Warsinski		$
			$
			$
			$
			$ 29.27

60/47

Mason St. ~~Pl.~~ ~~Ave.~~ No. 55

Name of Owner

Viele

Labor and Mat'l. Report July 23 1947

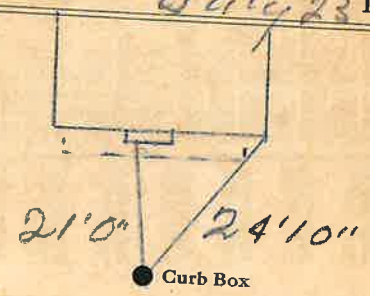

New 6" - 1970

~~4~~ Main

Elev. of Main at tap 4½

Gate at

Gate at

Curb Box

Tax Map # 302.12-25-12

ESM-5C-6-1-45