LABOR AND MATERIALS

1	Copper Lead } Connection	3/4	$ 1.59
1	Curb { Clock Valve T. S. & V. }	3/4 in.	$ 2.74
1	Service box Old returned { Short 3½X4½ Long 4½X5½ Buff or Rdway }		$ 1.82
23	Ft. 3/4 in. { Copper Galv. Iron Cast Iron } Pipe at 19		$ 3.80
	Nipples in. at		$
	Bushings to in. at		$
	Red'g Inc'g } Couplings to in. at		$
	Union in. at		$
	Meter in. at		$
	Lead Joints at		$
	Compound Joints at		$
1	Hrs. ~~Foreman~~ at Wm @ 84		$ .84
6	Hrs. Chauffeur at 75		$ 4.50
	Hrs. Tapper at		$
6	Hrs. Labor at .65		$ 3.90
	Hrs. Labor at		$
1	Hrs. Compressor at 47½		$ .88
	Compensation Ins.		$
	Trucking		$ 1.00
	Builders Use of Water. Paid		$ 5.00
	Tap by Warsinske		$
			$
			$
			$
			$ 26.07

34-45

St. 58
~~Pl.~~
~~Ave.~~ No. ~~52~~

Mason

Name of Owner

Tinkus

Labor and Mat'l. Report Nov. 1 1945

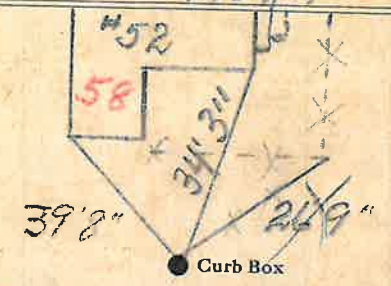

6" - 1970

4" Main

Elev. of Main at tap 4

Gate at ● ● Gate at

● Curb Box

Tax Map # 302.12-13.62

LSM-5C-6-1-45