## Labor and Materials

Copper / Lead } Connection ..... $ .....

Curb { Cock / Valve / T. S. & V. } ..... in ..... $ .....

Service Box / Old returned { Short 3½ x 4½ / Long 4½ x 5½ / Buff. or Rdway } ..... $ .....

.....Ft. .....in. { Copper / Galv Iron / Cast Iron } Pipe at ..... $ .....

..... Nipples .....in. at ..... $ .....

.....Bushings .....to .....in. at ..... $ .....

Red'g / Inc'g } Conplings .....to .....in. at ..... $ .....

.....Union .....in. at ..... $ .....

.....Meter .....in. at ..... $ .....

.....Lead Joints at ..... $ .....

.....Leadite Joints at ..... $ .....

.....Hrs. Foreman at ..... $ .....

.....Hrs. Chauffeur at ..... $ .....

.....Hrs. Tapper at ..... $ .....

.....Hrs. Labor at ..... $ .....

.....Hrs. Labor at ..... $ .....

.....Hrs. Compressor at ..... $ .....

.....Compensation Ins. ..... $ .....

.....Trucking ..... $ .....

.....Builders Use of Water ..... $ .....

..... $ .....

..... $ .....

..... $ .....

..... $ .....

$ .....

Mason St. / Pl. / Ave. 10 No. 6

**Name of Owner**

TAX ID # 302.12-16-11

**Labor and Mat'l. Report** 19

.....Main

Elev. of Main at tap..... .... .....

Gate at •

• Gate at

● Curb Box

## LABOR AND MATERIALS

| | | |
|---|---|---|
| 1 | Copper Lead — Connection 3/4 | $ 2.80 |
| 1 | Curb — Clock Valve T. S. & V. — 3/4 in. | $ 3.60 |
| 1 | Service box Old returned — Short 3½X4½ Long 4½X5½ Buff or Rdway | $ 5.80 |
| 19 | Ft. 3/4 in. — Copper Galv. Iron Cast Iron — Pipe at 35 | $ 6.65 |
| | Nipples in. at | $ |
| | Bushings to in. at | $ |
| | Red'g Inc'g Couplings to in. at | $ |
| | Union in. at | $ |
| | Meter in. at | $ |
| | Lead Joints at | $ |
| | Compound Joints at | $ |
| 2 | Hrs. Foreman at | $ 3.02 |
| 2 | Hrs. Chauffeur at | $ 1.82 |
| | Hrs. Tapper at | $ |
| 15 | Hrs. Labor at | $ 12.00 |
| | Hrs. Labor at | $ |
| | Hrs. Compressor at | $ |
| | Compensation Ins. | $ .35 |
| | Trucking | $ 1.— |
| | Builders Use of Water | $ — |
| Tap by Miller | | $ |
| | | $ |
| | | $ |
| | | $ |
| | | $36.04 |

St. Pl. Ave. No. 10

Mason

Name of Owner

Chase

Labor and Mat'l. Report July 28 19 47

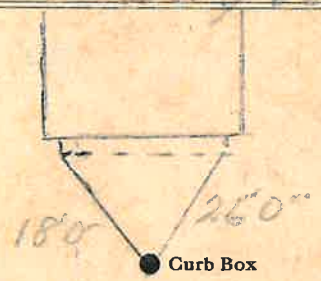


4 Main

Elev. of Main at tap 4'

Gate at ● ● Gate at

● Curb Box

LSM-SC-6-1-43