## Labor and Materials

| | | | |
|---|---|---|---|
| 1 | Copper / Lead | Connection | $ 1.46 |
| 1 | Curb | Cock / Valve / T. S. & V. ... in | $ 1.93 |
| 1 | Service Box / Old returned | Short 3½ x 4½ / ~~Long 4½ x 5½~~ / Buff. or Rdway | $ 1.77 |
| 19 | Ft. 3/4 in. | Copper / ~~Galv. Iron~~ / ~~Cast Iron~~ Pipe at 22 | $ 4.18 |
| | Nipples | in. at | $ |
| | Bushings | to in. at | $ |
| | Red'g / Inc'g | Couplings to in. at | $ |
| | Union | in. at | $ |
| | Meter | in. at | $ |
| | Lead Joints at | | $ |
| | Leadite Joints at | | $ |
| | Hrs. Foreman at | | $ |
| 3 | Hrs. Chauffeur at | 62½ | $ 1.88 |
| | Hrs. Tapper at | | $ |
| 16 | Hrs. Labor at | 45 | $ 7.20 |
| | Hrs. Labor at | | $ |
| | Hrs. Compressor at | | $ |
| | Compensation Ins. | | $ .28 |
| | Trucking | | $ 1.00 |
| | Builders Use of Water | Patch | $ 5.00 |
| | | | $ |
| | | | $ |
| | | | $ |
| | Tap by Pier | | $ |
| | | | $ 24.70 |

113-1937

St. 12
~~Pl.~~
Ave. No. 8

Mason

Name of Owner

Norton

Labor and Mat'l. Report Oct 22 1937

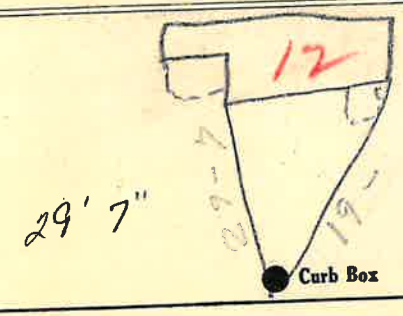


4 Main

Elev. of Main at tap 6½

Gate at

Gate at

Curb Box

old Shutoff