LABOR AND MATERIALS

1	Copper / ~~Lead~~ Connection	3/4"	$ 3.04
1	Curb ~~Cock Valve T. S. & V.~~	3/4 in.	$ 3.54
1	Service box Old returned ~~Short 3½x4½ Long 4½x5½ Buff or Rdway~~		$ 4.70
12 Ft.	3/4 in. ~~Copper G. I. C. I.~~ Pipe at	35	$ 4.20
	Nipples in. at		$
	Bushings to in. at		$
	Red'g / Inc'g Coupl'gs to in. at		$
	Union in. at		$
	Meter in. at		$
	Lead Joints at		$
	Compound Joints at		$
1	Hrs. Water Maint. Man—1 at	1.23	$ 1.23
7	Hrs. Water Maint. Man—2 at	1.13	$ 7.91
11	Hrs. Labor— at	1.02	$ 11.22
	Hrs. Labor— at		$
	Hrs. Compressor at		$
	Compensation Ins. at $2.66 per C.		$ .54
	Trucking		$ 1.00
	Pav't Patch		$
			$
			$
			$
	O'head		$
			$ 37.38

Tap by Gifford
June 15, 1951

94-1951

St. ~~Pl.~~ Ave. No. 5

Mauro

Name of Owner

Hopkins

Labor and Mat'l. Report June 15 1951

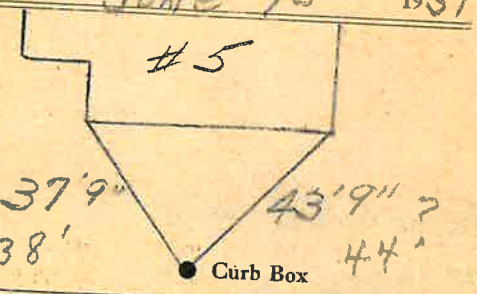

12" Main

Elev. of Main at tap 5'

Gate at

Gate at

Curb Box

Tax Map # 303.9-7-30

LSM-5C 10-21-49