Labor and Materials

1	Copper ~~Lead~~ Connection	3/4"	$ 1.46
1	Curb — Cock ~~Valve~~ ~~T. S. & V.~~	3/4" in	$ 1.93
1	Service Box Old returned — Short 3½ x 4½ ~~long 4½ x 5½~~ ~~Buff or Rdway~~		$ 1.77
10	Ft. 3/4" in. — Copper ~~Galv. Iron~~ ~~Cast Iron~~ Pipe at		$ 2.20
	Nipples in. at		$
	Bushings to in. at		$
	Red'g Inc'g Couplings to in. at		$
	Union in. at		$
	Meter in. at		$
	Lead Joints at		$
	Leadite Joints at		$
1	Hrs. Foreman at	31¼	$ .31
3	Hrs. Chauffeur at	62½	$ 1.88
5	Hrs. Tapper at	62½	$ 3.13
5	Hrs. Labor at	45	$ 2.25
	Hrs. Labor at		$
	Hrs. Compressor at		$
	Compensation Ins.		$
	Trucking		$ 1.00
	Builders Use of Water	Patch	$ 5.00
			$
			$
			$
Tap by Hessel			$
			$ 20.93

9 8 – 1937

May St. Pl. Ave. No. 16 10

Name of Owner

Hall

Labor and Mat'l. Report Left 9 1937

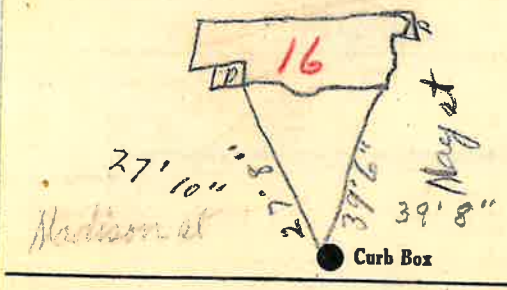

4" Main — Elev. of Main at tap 4

Gate at • • Gate at

● Curb Box

Old tap shut off

Tax map # 302.20-10-19

old