Labor and Materials

1	~~Lead~~ Connection 3/4	$
1	Curb Cock 3/4	$
1	Service Box Old returned { Short 3½ x 4½ / ~~Long 4½ x 6½~~ / Buffalo	$
6	Ft. 3/4 in. ~~G. I. Pipe~~ at Copper	$
	Nipples ..... in. at	$
	Bushings ..... to ..... in. at	$
	Red'g Coup .... to .... in. at	$
	Inc'g Coup .... to .... in. at	$
	Union .... in. at	$
	Meter .... in. at	$
	Cu. Yds. Br. Stone at	$
	Cu. Yds. Sand at	$
	Bags Cement at	$
	Paving Brick { Mack / Red / Asphalt } at	$
3	Hrs. Foreman at	$
13	Hrs. Common Labor at	$
	Hrs. Mason at	$
	Hrs. ..... at	$
	Hrs. ..... at	$
Inv.	Builders' Use of Water	$
	..... at	$
	Truck 100 ..... at	$
	..... at	$
	..... at	$
	Total	$ 13.87

June

...or and Material Report 7 1925

19 McDonald St

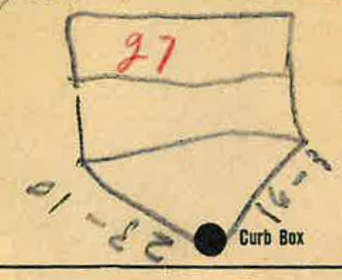

8"-1975

Main

Elev. of Main at tap 5½

Gate at ● ● Gate at

● Curb Box

TAX ID # 303.18-6-20
#25 - #27