LABOR AND MATERIALS

1	Copper / ~~Lead~~ Connection 3/4		$ 1.59
1	Curb { Clock / ~~Valve~~ / ~~T. S. & V.~~ } 3/4 in.		$ 2.74
1	Service box / Old returned { ~~Short 3½X4½~~ / Long 4½X5½ / ~~Buff or Rdway~~ }		$ 1.82
9	Ft. 3/4 in. { Copper / ~~Galv. Iron~~ / ~~Cast Iron~~ } Pipe at 19		$ 1.71
	Nipples in. at		$
	Bushings to in. at		$
	Red'g / Inc'g } Couplings to in. at		$
	Union in. at		$
	Meter in. at		$
	Lead Joints at		$
	Compound Joints at		$
	Hrs. Foreman at		$
6	Hrs. Chauffeur at	75	$ 4.50
10	Hrs. Tapper at		$ 7.50
8	Hrs. Labor at	65	$ 5.20
	Hrs. Labor at		$
1	Hrs. Compressor at	87½	$ .88
	Compensation Ins.		$ .46
	Trucking		$ 1.00
	Builders Use of Water	2	$ 5.00
	Taply Maquine		$
			$
			$
			$
			$ 32.40

17.20

26/45

McDonald

St. / Pl. / Ave. No. 41 ~~29~~

Name of Owner

O'Neil

Labor and Mat'l. Report Sept 25 1945

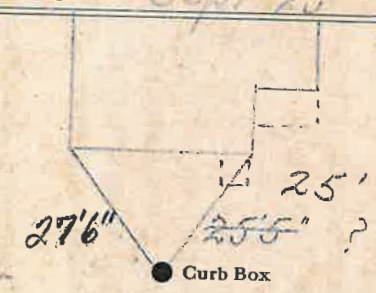

8"-1975

~~X~~" Main

Elev. of Main at tap 5½'

Gate at ●

● Gate at

TAX ID # 303.18-6-14

● Curb Box

LSM-5C-6-1-45