LABOR AND MATERIALS

1	Copper Lead — Connection	3/4	$ 2.80
1	Curb — Clock Valve T. S. & V.	3/4 in.	$ 3.60
1	Service box Old returned — Short 3½X4½ / Long 4½X5½ Buff or Rdway		$ 5.80
10 Ft.	3/4 in. — Copper / Galv. Iron / Cast Iron Pipe at 35		$ 3.50
	Nipples ... in. at		$
	Bushings ... to ... in. at		$
	Red'g Couplings Inc'g ... to ... in. at		$
	Union ... in. at		$
	Meter ... in. at		$
	Lead Joints at		$
	Compound Joints at		$
	Hrs. Foreman at		$
	Hrs. Chauffeur at		$
5	Hrs. Tapper at	82½	$ 4.15
15	Hrs. Labor at	71½	$ 10.72
	Hrs. Labor at		$
	Hrs. Compressor at		$
	Compensation Ins.		$ .33
	Trucking		$ 1.—
	Builders Use of Water		$ 2.30
Tap & Mag			$
			$
			$
			$
			$ 34.18

23/47

McDonald — St. Pl. Ave. No. 61

Name of Owner

O'Connor

Labor and Mat'l. Report May 12 1947

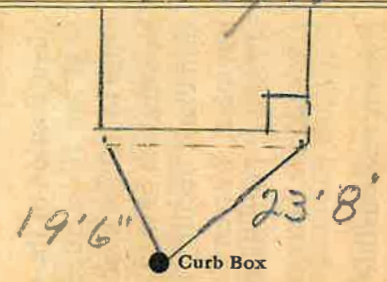

8"-1915

X Main

Elev. of Main at tap 6

Gate at ● ● Gate at

TAX ID # 303.18-1-6

● Curb Box

LSM-5C-6-1-45