13

St.
~~Pl~~
~~Ave.~~ No. 77

McDonald

Name of Owner Alfred Marcantano

Labor and Mat'l. Report Apr 13 1948

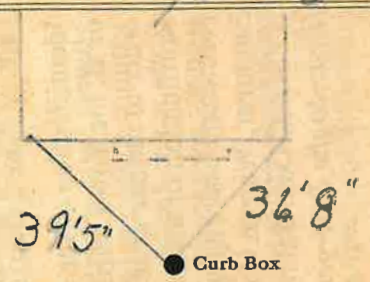

8" 1975 Main

Elev. of Main at tap 5

Gate at ●

● Gate at

TAX ID #303.14-2-22

● Curb Box

LSM-5C-6-1-45

LABOR AND MATERIALS

1 Copper Lead	Connection 3/4	$ 2.94
1 Curb	Clock Valve ~~I. S. & V.~~ 3/4 in.	$ 3.71
1 Service box ~~Old~~ returned	~~Short 3½X4½~~ ~~Long 4½X5½~~ Buff or Rdway	$ 5.90
10 Ft. 3/4 in.	~~Copper~~ ~~Galv. Iron~~ Cast Iron Pipe at 30	$ 3.00
... Nipples ... in. at		$
... Bushings ... to ... in. at		$
... Red'g Inc'g Couplings ... to ... in. at		$
... Union ... in. at		$
... Meter ... in. at		$
... Lead Joints at		$
... Compound Joints at		$
... Hrs. Foreman at		$
4 Hrs. ~~Chauffeur at~~ WMM-2	91	$ 3.64
... Hrs. Tapper at		$
12 Hrs. Labor at	80	$ 9.60
... Hrs. Labor at		$
... Hrs. Compressor at		$ .29
... Compensation Ins.		$ 1.00
... Trucking		$ 12.70
... Builders Use of Water Patch		$
Tap by Maguire		$
		$
		$
		$ 43.78