5 - - 1940

St. 100

Pl.

McDonald Ave. No. 86

Name of Owner

Delsignore

Labor and Mat'l. Report May 22 1940

100

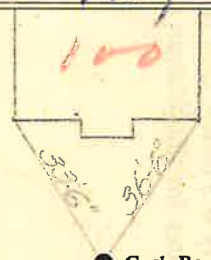

Curb Box

8"-1975

4 Main

Elev. of Main at tap 5

Gate at ● ● Gate at

TAX ID # 303.13-22-9

● Curb Box

New House

LABOR AND MATERIALS

1 Copper / ~~Lead~~ } Connection 3/4 $ 1.31

1 Curb { Cock / ~~Valve~~ / T. S. & V. } 3/4 in. $ 1.75

1 Service Box Old returned { Short 3½x4½ / Long 4½x5½ / Buff. or Rdway } $ 1.60

24 Ft. 3/4 in. { Copper / Galv Iron / Cast Iron } Pipe at 18 $ 4.32

____ Nipples ____ in. at $

____ Bushings ____ to ____ in. at $

Red'g / Inc'g } Couplings ____ to ____ in. at $

____ Union ____ in. at $

____ Meter ____ in. at $

____ Lead Joints at $

____ Leadite Joints at $

____ Hrs. Foreman at $

2 Hrs. Chauffeur at 62½ $ 1.25

____ Hrs. Tapper at $

4 Hrs. Labor at 45 $ 1.80

____ Hrs. Labor at $

____ Hrs. Compressor at $

____ Compensation Ins. $ 10

____ Trucking $ 1 —

____ Builders Use of Water ½ Patch (Sewer) $ 2.50

Top by Person $

$

$

$

$ 15.63