Labor and Materials

1	Lead Connection 3/4	$ 3.20
1	Curb Cock 3/4	$ .95
1	Service Box { Short 3½ x 4½ / Long 4½ x 5½ / Buffalo } Old returned	$
19 3/4	Ft. in. G. I. Pipe at Copper	$ 4.18
	Nipples ..... in. at	$
	Bushings ..... to ..... in. at	$
	Red'g Coup .... to .... in. at	$
	Inc'g Coup .... to .... in. at	$
	Union .... in. at	$
	Meter .... in. at	$
	Cu. Yds. Br. Stone at	$
	Cu. Yds. Sand at	$
	Bags Cement at	$
	Paving Brick { Mack / Red / Asphalt } at	$
3 2/3	Hrs. Foreman at	$ 2.30
11 1/2	Hrs. Common Labor at	$ 5.90
	Hrs. Mason at	$
	Hrs. at	$
	Hrs. at	$
No	Builders' Use of Water	$
	at	$
	Tax Use at	$ 1.27
	at	$
	at	$
	Total	$ 17.80

Labor and Material Report 19

143 Mission St.

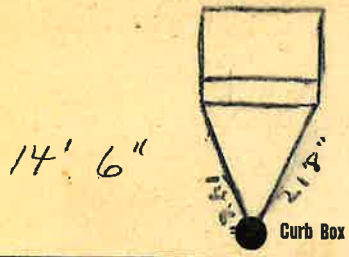

Main

Elev. of Main at tap

Gate at

Gate at

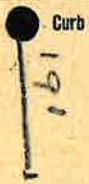

#1

Tax ID

309.35-1-14