Labor and Materials

1	Lead Connection	3/4	$
1	Curb Cock	3/4	$
1	Service Box { Short 3½ x 4½ / Long 4½ x 5½ / Buffalo } Old returned		$
13	Ft. 3/4 in. G. I. Pipe at Cop		$
	Nipples in. at		$
	Bushings to in. at		$
	Red'g Coup to in. at		$
	Inc'g Coup to in. at		$
	Union in. at		$
	Meter in. at		$
	Cu. Yds. Br. Stone at		$
	Cu. Yds. Sand at		$
	Bags Cement at		$
	Paving Brick { Mack / Red / Asphalt } at		$
2	Hrs. Foreman at		$
8½	Hrs. Common Labor at		$
	Hrs. Mason at		$
	Hrs.	at	$
	Hrs.	at	$
NO	Builders' Use of Water		$
Truck		at	$
		at	$
		at	$
		at	$
	Total		$ 12.80

Labor and Material Report 19

16 and 18 Mission St.

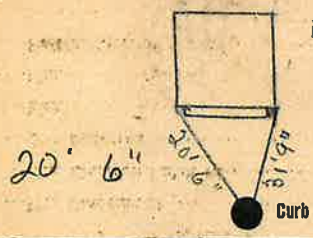

Main — Elev. of Main at tap

Gate at ● — ● Gate at

Curb box inside of walk.