Labor and Materials

1	Lead Connection 3/4	$ 3.20
1	Curb Cock 3/4	$ 1.85
1	Service Box { Short 3½ x 4½ / Long 4½ x 5½ / Buffalo } Old returned	$
19 Ft.	3/4 in. G. I. Pipe at Cop	$ 4.18
	Nipples ... in. at	$
	Bushings ... to ... in. at	$
	Red'g Coup ... to ... in. at	$
	Inc'g Coup ... to ... in. at	$
	Union ... in. at	$
	Meter ... in. at	$
	Cu. Yds. Br. Stone at	$
	Cu. Yds. Sand at	$
	Bags Cement at	$
	Paving Brick { Mack / Red / Asphalt } at	$
3 2/3	Hrs. Foreman at	$ 2.30
14 1/2	Hrs. Common Labor at	$ 5.90
	Hrs. Mason at	$
	Hrs. at	$
	Hrs. at	$
NO	Builders' Use of Water	$
Louis Lano	at	$ 2.22
TRUCK	at	$ 1.50
	at	$
	at	$
	Total	$ 17.50

16.1
25.9

abor and Material Report 19

5 Mission St.

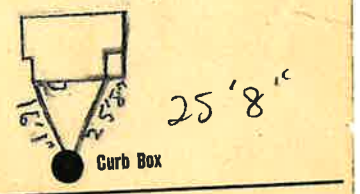

Main

Elev. of Main at tap

ate at ●

● Gate at

Tax ID# 309.35-1-13