Labor and Materials

1	Lead Connection ¾	$ 3.20
1	Curb Cock ¾	$ 1.00
1	Service Box Old returned { Short 3½ x 4½ / Long 4½ x 5½ / Buffalo	$
7	Ft. ¾ in. G. I. Pipe at 25¢	$ 1.75
	Nipples ... in. at	$
	Bushings ... to ... in. at	$
	Red'g Coup ... to ... in. at	$
	Inc'g Coup ... to ... in. at	$
	Union ... in. at	$
	Meter ... in. at	$
	Cu. Yds. Br. Stone at	$
	Cu. Yds. Sand at	$
	Bags Cement at	$
	Paving Brick { Mack / Red / Asphalt } at	$
1	Hrs. Foreman at	$ 1.25
8¼	Hrs. Common Labor at	$ 3.35
	Hrs. Mason at	$
	Hrs. ... at	$
	Hrs. ... at	$
	Builders' Use of Water	$
	Trucks at	$ 1.50
	Comp. Use at	$ .12
	at	$
	Total	$ 11.47

Labor and Material Report 19

6 Mission St.

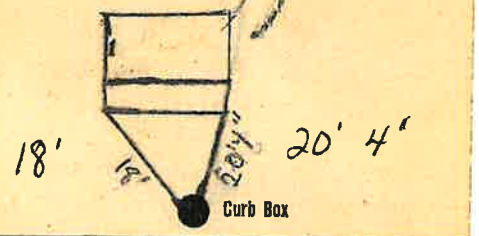

Main

Elev. of Main at tap

Gate at
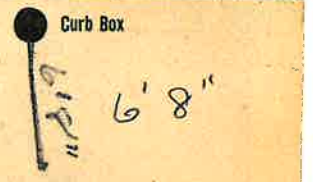
Gate at