Labor and Materials

1	Lead Connection	$ 3.20
1	Curb Cock	$ 1.50
1	Service Box Old returned { Short 3½ x 4½ / Long 4½ x 5½ / Buffalo }	$
7 3/4	Ft. in. G. I. Pipe at cop	$ 1.75
	Nipples in. at	$
	Bushings to in. at	$
	Red'g Coup to in. at	$
	Inc'g Coup to in. at	$
	Union in. at	$
	Meter in. at	$
	Cu. Yds. Br. Stone at	$
	Cu. Yds. Sand at	$
	Bags Cement at	$
	Paving Brick { Mack / Red / Asphalt } at	$
2	Hrs. Foreman at	$ 1.25
8 1/4	Hrs. Common Labor at	$ 3.50
	Hrs. Mason at	$
	Hrs. at	$
	Hrs. at	$
1/2	Builders' Use of Water	$
	at	$
Truck	at	$ 1.00
Dump Chg.	at	$ .12
	at	$
	Total	$ 11.73

Labor and Material Report 19

8 Mission St.

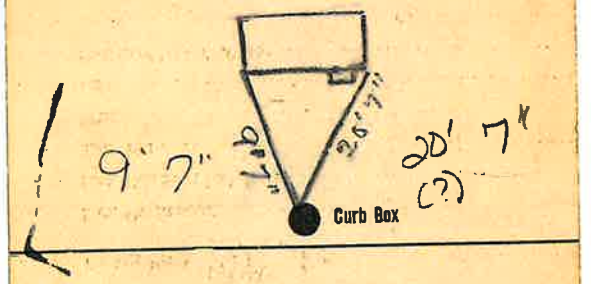

Main

Elev. of Main at tap

Gate at ●

● Gate at