Labor and Materials

1	Lead Connection 3/4	$
1	Curb Cock 3/4	$
1	Service Box Old returned { Short 3½ x 4½ / Long 4½ x 5½ / Buffalo	$
7	Ft. 3/4 in. G. I. Pipe at Cap	$
	Nipples ..... in. at	$
	Bushings ..... to ..... in. at	$
	Red'g Coup .... to .... in. at	$
	Inc'g Coup .... to .... in. at	$
	Union .... in. at	$
	Meter .... in. at	$
	Cu. Yds. Br. Stone at	$
	Cu. Yds. Sand at	$
	Bags Cement at	$
	Paving Brick { Mack / Red / Asphalt } at	$
2	Hrs. Foreman at	$
8¼	Hrs. Common Labor at	$
	Hrs. Mason at	$
	Hrs. ..... at	$
	Hrs. ..... at	$
10	Builders' Use of Water	$
	..... at	$
	Truck ..... at	$
	..... at	$
	..... at	$
	Total	$ 11.58

33.3

Labor and Material Report 19

10 Mission St.

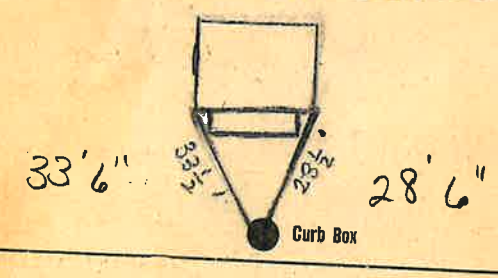

Main

Elev. of Main at tap

Gate at

Gate at

Tax ID# 309.7-13-1