Labor and Materials

1	~~Lead Connection~~ 3/4	$
1	Curb Cock 3/4	$
1	Service Box Old returned { Short 3½ x 4½ / Long 4½ x 5½ / Buffalo }	$
25	Ft. in. G. I. Pipe at Cop	$
	Nipples in. at	$
	Bushings to in. at	$
	Red'g Coup to in. at	$
	Inc'g Coup to in. at	$
	Union in. at	$
	Meter in. at	$
	Cu. Yds. Br. Stone at	$
	Cu. Yds. Sand at	$
	Bags Cement at	$
	Paving Brick { Mack / Red / Asphalt } at	$
3½	Hrs. Foreman at	$
1.4½	Hrs. Common Labor at	$
	Hrs. Mason at	$
	Hrs. at	$
	Hrs. at	$
No	Builders' Use of Water	$
	at	$
	9 mark at	$
	at	$
	at	$
	Total	$ 19.12

Labor and Material Report 19

11 Mission ST.

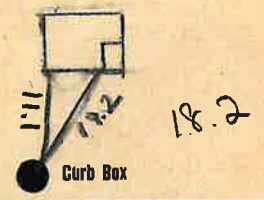

10" Main

Elev. of Main at tap

Gate at ●

● Gate at

Tax ID
309.35-1-10