## LABOR AND MATERIALS

| | | | |
|---|---|---|---|
| 1 | Copper / ~~Lead~~ Connection | 3/4" | $ 2.71 |
| 1 | Curb { Cock / ~~Valve~~ / ~~T. S. & V.~~ } | 3/4 in. | $ 3.83 |
| 1 | Service box Old returned { ~~Short 3½ x 4½~~ / Long 4½ x 5½ / ~~Buff or Rdway~~ } | | $ 4.64 |
| 23 | Ft. 3/4 in. { Copper / ~~G. I.~~ / ~~C. I.~~ } Pipe at | 45 | $ 5.85 |
| | Nipples in. at | | $ |
| | Bushings to in. at | | $ |
| | Red'g / Inc'g Coupl'gs to in. at | | $ |
| | Union in. at | | $ |
| | Meter in. at | | $ |
| | Lead Joints at | | $ |
| | Compound Joints at | | $ |
| | Maintenance Foreman | | $ ~~4.76~~ |
| | Hrs. Water Maint. Man—1 at | | $ |
| 7 | Hrs. Water Maint. Man—2 at | 1.24 | $ 8.68 |
| | Hrs. Garage Foreman at | | $ |
| 16 | Hrs. Labor— at | 1.13 | $ 18.08 |
| | Hrs. Compressor at | | $ |
| | Compensation Ins. at $4.29 per C | | $ 1.15 |
| | Trucking | | $ 1.50 |
| | Pay't Patch | | $ 11.20 |
| Tap by Gifford 10-25-55 | | | $ |
| | | | $ |
| | | | $ |
| | O'head | | $ |
| | | | $ 57.69 |

46.49

Mohican St. / ~~Pl.~~ / ~~Ave.~~ No. 25

Name of Owner

Russo

Labor and Mat'l. Report Oct. 25 1955

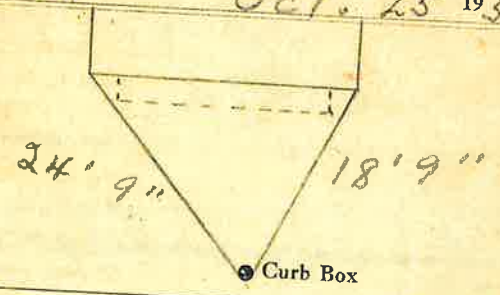


4" Main

Elev. of Main at tap 6'

Gate at ●

● Gate at

● Curb Box

L M—5C—2-1-54