Labor and Materials

1	Copper / ~~Lead~~ Connection 3/4	$ 3.20
1	Curb { Cock / Valve / T. S. & V. } 3/4 in.	$ 1.00
	Service Box Old returned { Short 3½ x 4½ / Long 4½ x 5½ / Buff. or Rdway }	$ 1.30
16	Ft. 3/4 in. { Copper / Galv. Iron / Cast Iron } Pipe at	$ 3.52
	Nipples ..... in. at	$
1	Bushings 3/4" to 1/2" in. at	$ 0.8
	Red'g / Inc'g Couplings ..... to ..... in. at	$
	Union ..... in. at	$
	Meter ..... in. at	$
	Lbs. Br. Stone at	$
	Lbs. Sand at	$
	Bags Cement at	$
	Paving Brick { Mack / Red / Asphalt } at	$
	Lead Joints at	$
	Leadite Joints at	$
1	Hrs. Foreman at 62.5	$ 6.3
1	Hrs. Common Labor at 5.0	$ 5.0
13	Hrs. Common Labor at 40 1/8	$ 5.28
	Hrs. Mason at	$
	Hrs Mason's Helper at	$
	Hrs. Compressor at	$
	Compensation Ins.	$ 18
	Trucking	$ 1.00
	Builders' Use of Water	$ 1.00
	Total	$ 16.69

37

Labor and Material Report 19

3/4" tap at 19 Madison St

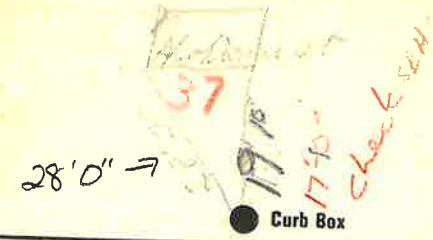

4" Main

Elev. of Main at tap

Gate at

Gate at

Curb Box

W-L-P Dunkel