LABOR AND MATERIALS

1	Copper ~~Lead~~ Connection	3/4"	$ 2.71
1	Curb ~~Clock~~ ~~Valve~~ ~~T. S. & V.~~	3/4 in.	$ 2.83
1	Service box Old returned ~~Short 3½X4½~~ ~~Long 4½X5½~~ ~~Buff or Rdway~~		$ 4.69
19 ~~20~~	Ft. 3/4 in. ~~Copper~~ ~~Galv. Iron~~ ~~Cast Iron~~ Pipe at 45		$ 9.90
	Nipples 7/10/12 in. at		$
	Bushings to in. at		$
	~~Red'g~~ ~~Inc'g~~ Couplings to in. at		$
	Union in. at		$
	Meter in. at		$ 84.18
	Lead Joints at		$
	Compound Joints at		$ 3.50
	Hrs. Foreman at		$
12	Hrs. ~~Chauffeur~~ at M.M. 2-1.24		$ 14.88
	Hrs. Tapper at		$
20	Hrs. Labor at 1.13		$ 22.60
	Hrs. Labor at		$
	Hrs. Compressor at		$
	Compensation Ins. 5.686		$ 2.13
	Trucking		$ 1.50
	Builders Use of Water		$ 10.30
	Tap by Gifford 12-29-55		$
			$
			$
			$ 73.04

St. ~~Pl.~~ 60
Mahican Ave. No. 36

Name of Owner

Atiyeh

Labor and Mat'l. Report Dec. 29 1955

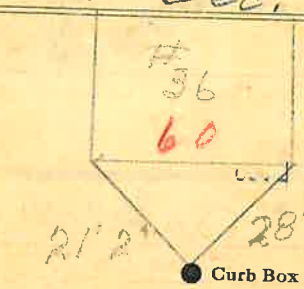

7-5/70 31

4" Main

Elev. of Main at tap JK

Gate at ● ● Gate at

● Curb Box

Tax ID # 309.36-3-9

LSM-5C-6-1-45