LABOR AND MATERIALS

1	Copper / Lead } Connection 3/4		$ 1.59
1	Curb { Clock / ~~Valve~~ / ~~T. S. & V.~~ } 3/4 in.		$ 2.74
	Service box / ~~Old returned~~ { ~~Short 3½X4½~~ / ~~Long 4½X5½~~ / Buff or Rdway } Same		$
5	Ft. 3/4 in. { Copper / ~~Galv. Iron~~ / ~~Cast Iron~~ } Pipe at 19		$ 95
	Nipples in. at		$
	Bushings to in. at		$
	Red'g / Inc'g } Couplings to in. at		$
	Union in. at		$
	Meter in. at		$
	Lead Joints at		$
	Compound Joints at		$
	Hrs. Foreman at		$
10	Hrs. Chauffeur at	68 3/4	$ 6.87
	Hrs. Tapper at		$
	Hrs. Labor at		$
	Hrs. Labor at		$
	Hrs. Compressor at		$
	Compensation Ins.		$ 18
	Trucking		$ 1.00
	Builders Use of Water		$ 5.00
	Tap by Warsinski		$
			$
			$
			$
			$ 18.33

21-45

Monroe

St. 16
~~Pl.~~
Ave. No. 5

Name of Owner

O'Connor

Labor and Mat'l. Report Aug 6 1945

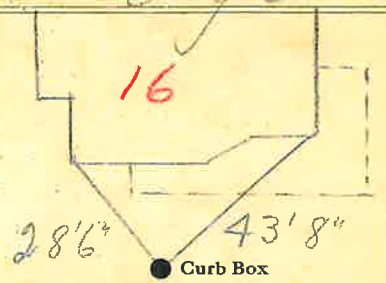

6 Main

Elev. of Main at tap 5

Gate at ● ● Gate at

● Curb Box

Tax ID # 302.16-11-24

LSM-5C-6-1-45