St. ~~Pl.~~ 8
Monroe Ave. No. 11

Name of Owner

Labor and Mat'l. Report Aug. 21 1939

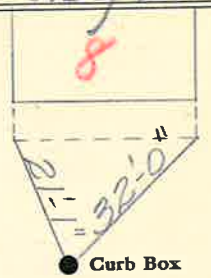

Main Elev. of Main at tap

Gate at ● ● Gate at

● Curb Box

St. Pl. Ave. No. 8
MONROE

Name of Owner

Labor and Mat'l. Report 19

LFT 20FT
RT 31.5 FT

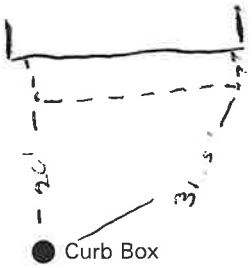

9' Main Elev. of Main at tap

Gate at ● ● Gate at

● Curb Box

9' of BLACK POLY
3/4" PIPE TO MAIN

TAX ID# 302.16-11-20

LABOR AND MATERIALS

Copper / Lead } Connection _____ $_____

Curb { Cock / Valve / T. S. & V. } _____ in. _____ $_____

Service Box Old returned { Short 3 1/2 x 4 1/2 / Long 4 1/2 x 5 1/2 / Buff. or Rdway } _____ $_____

_____ Ft. _____ in. { Copper / Galv Iron / Cast Iron } Pipe at _____ $_____

_____ Nipples _____ in. at _____ $_____

_____ Bushings _____ to _____ in. at _____ $_____

Red'g / Inc'g } Couplings _____ to _____ in. at _____ $_____

_____ Union _____ in. at _____ $_____

_____ Meter _____ in. at _____ $_____

_____ Lead Joints at _____ $_____

_____ Leadite Joints at _____ $_____

_____ Hrs. Foreman at _____ $_____

_____ Hrs. Chauffeur at _____ $_____

_____ Hrs. Tapper at _____ $_____

_____ Hrs. Labor at _____ $_____

_____ Hrs. Labor at _____ $_____

_____ Hrs. Compressor at _____ $_____

_____ Compensation Ins. _____ $_____

_____ Trucking _____ $_____

_____ Builders Use of Water _____ $_____

_____ $_____

_____ $_____

_____ $_____

_____ $_____

$_____

LABOR AND MATERIALS

_____ Copper / Lead } Connection _____ $_____

_____ Curb { Cock / Valve / T.S. & V. } _____ in. _____ $_____

_____ Service box Old returned { Short 3-1/2 x 4-1/2 / Long 4-1/2 x 5-1/2 } _____ $_____

_____ Ft. _____ in. { Copper / G.I. / C.I. } Pipe at _____ $_____

_____ Nipples _____ in. at _____ $_____

_____ Bushings _____ to _____ in. at _____ $_____

_____ Red'g

_____ Inc'g

_____ Union _____ in. at _____ $_____

_____ Meter _____ in. at _____ $_____

_____ _____ $_____

_____ Compound Joints at _____ $_____

_____ Maintenance Foreman _____ $_____

_____ Hrs. Water Maint. Man - 1 at _____ $_____

_____ Hrs. Water Maint. Man - 2 at _____ $_____

_____ Hrs. Garage Foreman _____ at _____ $_____

_____ Hrs. Labor _____ at _____ $_____

_____ Hrs. Compressor at _____ $_____

_____ _____ $_____

_____ Trucking _____ $_____

_____ Pav't Patch _____ $_____

_____ _____ $_____

_____ _____ $_____

_____ _____ $_____

_____ _____ $_____

$_____