Labor and Materials

1	Lead Connection	3/4	$
1	Curb Cock	1"	$
1	Service Box / Old returned	Short 3½ x 4½ / Long 4½ x 5½ / ~~Buffalo~~	$
6	Ft. 1 in. G. I. Pipe at		$
	Nipples in. at		$
	Bushings to in. at		$
	Red'g Coup to in. at		$
	Inc'g Coup to in. at		$
	Union in. at		$
	Meter in. at		$
	Cu. Yds. Br. Stone at		$
	Cu. Yds. Sand at		$
	Bags Cement at		$
	Paving Brick (Mack / Red / Asphalt) at		$
3	Hrs. Foreman at		$
9	Hrs. Common Labor at		$
	Hrs. Mason at		$
	Hrs. at		$
	Hrs. at		$
9m	Builders' Use of Water		$
	at		$
	Truck Lod at		$
	at		$
	at		$
	Total		$ 12.38

Labor and Material Report

April 17 1928

3/4 Top Rend 138 Front Calen

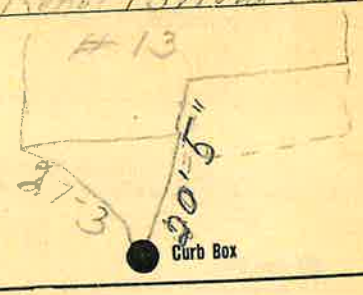

10 Main

Elev. of Main at tap 6

Gate at

Gate at

Curb Box

Tax ID# 309.27-2-24