LABOR AND MATERIALS

1 Copper ~~Lead~~	Connection 3/4	$ 1.23
1 Curb { Cock / ~~Valve~~ / ~~T. S. & V.~~ }	3/4 in.	$ 1.68
1 Service Box Old returned { ~~Short 3½x4½~~ / ~~Long 4½x5½~~ / ~~Buff. or Rdway~~ }		$ 1.54
9 Ft. 3/4 in. { ~~Copper~~ / ~~Galv Iron~~ / ~~Cast Iron~~ }	Pipe at 17	$ 1.53
____ Nipples ____ in. at		$
____ Bushings ____ to ____ in. at		$
~~Red'g~~ ~~Inc'g~~	Couplings ____ to ____ in. at	$
____ Union ____ in. at		$
____ Meter ____ in. at		$
____ Lead Joints at		$
____ Leadite Joints at		$
____ Hrs. Foreman at		$
2 Hrs. Chauffeur at 62½		$ 1.25
6 Hrs. Tapper at ~~-~~		$ 3.75
6 Hrs. Labor at .45		$ 2.70
____ Hrs. Labor at		$
____ Hrs. Compressor at		$
____ Compensation Ins.		$ .24
____ Trucking		$ 1.—
____ Builders Use of Water Patch		$ .5—
Tapley Hassel		$
		$
		$
		$
		$ 19.92

8 2 - 1939

St. ~~Pl.~~ Ave. No. 31

Montcalm

Name of Owner

Mrs Callie Head

Labor and Mat'l. Report Oct 3 1939

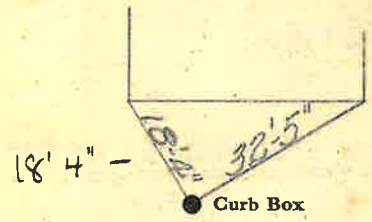

Oliver St

1 Main

Elev. of Main at tap 5

Gate at ●

● Gate at

● Curb Box

This top is on Oliver St

Tax ID # 309.27-5-6

old Shut off