LABOR AND MATERIALS

1	Copper ~~Lead~~	Connection 3/4" Brass ELL Oriseal.	$
1	Curb { Clock / ~~Valve (T. S. & V.)~~ }	3/4 in.	$
1	Service box Old returned	{ Short 3¼X4⅛ / Long 4¼X5⅛ / ~~Buff or Rdway~~ }	$
16	Ft. 3/4 in.	{ Copper / ~~Galv. Iron~~ / ~~Cast Iron~~ } Pipe at	$
1	Nipples	4 Long in. at Brass	$
	Bushings	3/4" to 1/2 in. at Brass	$
1	~~Red'g~~ / ~~Inc'g~~	Couplings 3/4" to 3/4" in. at Brass,	$
	Union	in. at	$
	Meter	in. at	$
	Lead Joints at		$
	Compound Joints at		$
	Hrs. Foreman at		$
	Hrs. Chauffeur at		$
	Hrs. Tapper at		$
	Hrs. Labor at		$
	Hrs. Labor at		$
	Hrs. Compressor at		$
	Compensation Ins.		$
	Trucking		$
	Builders Use of Water		$
	Tap by Lareau & Co		$
	9-30-69		$
	This Tap is on Oliver St.		$
			$
			$

St. ~~Pl.~~ Ave. No. 39

Montcalm

Name of Owner

Lewis.

Labor and Mat'l. Report Sept. 30 1969

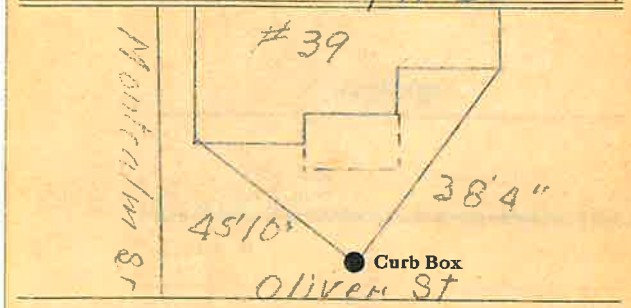

4" Main

Elev. of Main at tap 5'

Gate at ●

● Gate at

● Curb Box

Tax ID # 309.7-11-33

LSM-5C-6-1-45