LABOR AND MATERIALS

3/4 Copper ~~Lead~~ Connection _____ $ _____

_____ Curb { Cock / Valve / T.S. & V. } _____ in. _____ $ _____

_____ Service box / Old returned { Short 3-1/2 x 4-1/2 / Long 4-1/2 x 5-1/2 } _____ $ _____

16 Ft. 7 in. { Copper / G.I. / C.I. } Pipe at _____ $ _____

_____ Nipples _____ in. at _____ $ _____

_____ Bushings _____ to _____ in. at _____ $ _____

_____ Red'g

_____ Inc'g

_____ Union _____ in. at _____ $ _____

_____ Meter _____ in. at _____ $ _____

_____ _____ $ _____

_____ Compound Joints at _____ $ _____

_____ Maintenance Foreman _____ $ _____

_____ Hrs. Water Maint. Man - 1 at _____ $ _____

_____ Hrs. Water Maint. Man - 2 at _____ $ _____

_____ Hrs. Garage Foreman _____ at _____ $ _____

_____ Hrs. Labor _____ at _____ $ _____

_____ Hrs. Compressor at _____ $ _____

_____ _____ $ _____

_____ Trucking _____ $ _____

_____ Pav't Patch _____ $ _____

_____ _____ $ _____

_____ _____ $ _____

_____ _____ $ _____

_____ _____ $ _____

_____ _____ $ _____

MONTCALM St. Pl. Ave. No. 45

Name of Owner

Labor and Mat'l. Report ~~10~~ 11/29/11

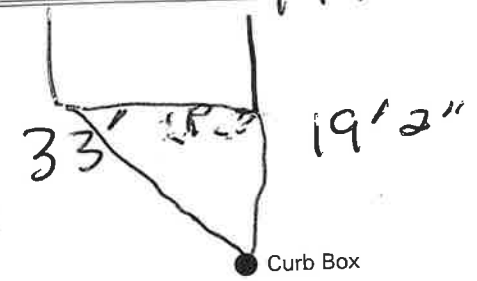

10' Main

Elev. of Main at tap 6'

Gate at ●

● Gate at

_____ _____

● Curb Box

Tax ID# 309.7-11-30

Labor and Materials

1 Lead Connection 3/4 ..... $.....

1 Curb Cock 1 ..... $.....

1 Service Box Old returned { Short 3½ x 4½ ~~Long 4½ x 5½~~ Buffalo } $.....

7 Ft. 1 in. G. I. Pipe at ..... $.....

7 Nipples ..... in. at ..... $.....

1 Bushings 1 to 1/2 in. at ..... $.....

Red'g Coup .... to .... in. at ..... $.....

Inc'g Coup .... to .... in. at ..... $.....

Union .... in. at ..... $.....

Meter .... in. at ..... $.....

Cu. Yds. Br. Stone at ..... $.....

Cu. Yds. Sand at ..... $.....

Bags Cement at ..... $.....

Paving Brick { Mack / Red / Asphalt } at ..... $.....

2 Hrs. Foreman at ..... $.....

6 Hrs. Common Labor at ..... $.....

Hrs. Mason at ..... $.....

Hrs. ..... at ..... $.....

Hrs. ..... at ..... $.....

Inc. Builders' Use of Water ..... $.....

..... at ..... $.....

Truck 1.00 ..... at ..... $.....

..... at ..... $.....

..... at ..... $.....

Total $ 10.68

Oct.

Labor and Material Report 24 **19**

45 Montclair St.

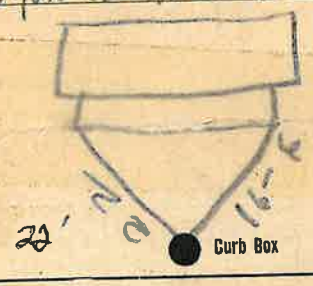

10 Main

Elev. of Main at tap 5

Gate at ●

● Gate at

● Curb Box