Labor and Materials

1 Copper / ~~Lead~~ Connection 3/4" $1.25

1 Curb { Cock / Valve / T.S.&V. } 3/4 in $1.70

1 Service Box / Old returned { Short 3½x4½ / ~~Long 4½x5½~~ / ~~Buff. or Rdway~~ } $1.37

~~12~~ Ft. ..... in { Copper / ~~Galv. Iron~~ / ~~Cast Iron~~ } Pipe at 13¢ $1.62

..... Nipples ..... in. at ..... $.....

1 Bushings 3/4 to 1/2 in. at ..... $.05

~~Red'g~~ / Inc'g Couplings ..... to ..... in. at ..... $.....

..... Union ..... in. at ..... $.....

..... Meter ..... in. at ..... $.....

..... Lbs. Br. Stone at ..... $.....

..... Lbs. Sand at ..... $.....

..... Bags Cement at ..... $.....

..... Paving Brick { Mack / Red / Asphalt } at ..... $.....

..... Lead Joints at ..... $.....

..... Leadite Joints at ..... $.....

2 Hrs. Foreman at 67½ $1.75

1 Hrs. Common Labor at ..... $.50

6½ Hrs. Common Labor at 45 ..... $2.93

..... Hrs. Mason at ..... $.....

..... Hrs. Masons Helper at ..... $.....

..... Hrs. Compressor at ..... $.....

..... Compensation Ins ..... $.18

..... Trucking ..... $1.—

..... Builders Use of Water ..... $.....

Total $11.85

1935-136

Labor and Material Report Aug 24 1935

3/4" tap at 57 Main Calm St.

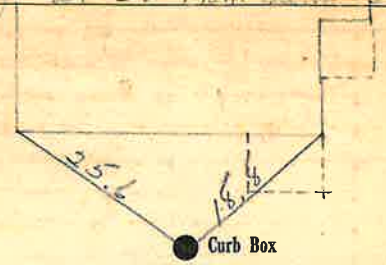

6" Main

Elev of Main at tap 5'

Gate at ● ● Gate at

● Curb Box

old Shut off at main

Tax ID # 309.7-11-24.1