Labor and Materials

1	Copper / Lead Connection 3/4"	$ 1.25
1	Curb (Cock / Valve / T.S.&V.) 3/4 in	$ 1.70
1	Service Box Old returned (Short 3½x4½ / Long 4½x5½ / Buff. or Rdway)	$ 1.37
11	Ft. in. (Copper / Galv. Iron / Cast Iron) Pipe at 13¢	$ 1.43
	Nipples in. at	$
1	Bushings 3/4 to 1/2 in. at	$ .05
	(Red'g / Inc'g) Couplings to in. at	$
	Union in. at	$
	Meter in. at	$
	Lbs. Br. Stone at	$
	Lbs. Sand at	$
	Bags Cement at	$
	Paving Brick (Mack / Red / Asphalt) at	$
	Lead Joints at	$
	Leadite Joints at	$
2	Hrs. Foreman at 62½	$ 1.25
1	Hrs. Common Labor at	$ .50
6½	Hrs. Common Labor at 45	$ 2.93
	Hrs. Mason at	$
	Hrs. Masons Helper at	$
	Hrs. Compressor at	$
	Compensation Ins	$ .18
	Trucking	$ 1.75
	Builders Use of Water	$

Total $ 11.77

1935-138

Labor and Material Report Aug 24 1935

3/4" tap at 61 Montcalm St.

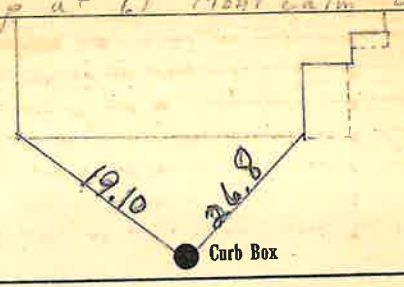

6" Main

Elev. of Main at tap 5'

Gate at ● ● Gate at

● Curb Box

old blow off at Division

Tax ID# 309.7-11-22