Labor and Materials

1	Lead Connection 3/4	$
1	Curb Cock 1	$
1	Service Box (Short 3½ x 4½ / Long 4½ x 5½ / ~~Old returned~~ Buffalo)	$
11	Ft. 1 in. G. I. Pipe at	$
	Nipples ... in. at	$
	Bushings ... to ... in. at	$
	Red'g Coup ... to ... in. at	$
	Inc'g Coup ... to ... in. at	$
	Union ... in. at	$
	Meter ... in. at	$
	Cu. Yds. Br. Stone at	$
	Cu. Yds. Sand at	$
	Bags Cement at	$
	Paving Brick (Mack / Red / Asphalt) at	$
1	Hrs. Foreman at	$
2	Hrs. Common Labor at	$
	Hrs. Mason at	$
	Hrs. at	$
	Hrs. at	$
Jan.	Builders' Use of Water	$
	at	$
Truck	at	$
	at	$
	at	$
	Total	$ 11.87

Oct.

Labor and Material Report 29 19

75 Montcalm St.

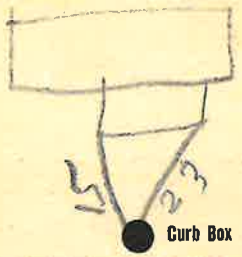

6 Main

Elev. of Main at tap

Gate at ●

● Gate at

● Curb Box

Tax ID# 309.7-11-16