Labor and Materials

1	Lead Connection ¾"	$ 2.69
1	Curb Cock 1"	$ 1.76
1	Service Box { Short 3½ x 4½ / Long 4½ x 5½ / Buffalo } Old returned	$
8	Ft. 1" in. G. I. Pipe at	$ 1.56
	Nipples in. at	$
	Bushings to in. at	$
	Red'g Coup to in. at	$
	Inc'g Coup to in. at	$
	Union in. at	$
	Meter in. at	$
	Cu. Yds. Br. Stone at	$
	Cu. Yds. Sand at	$
	Bags Cement at	$
	Paving Brick { Mack / Red / Asphalt } at	$
3	Hrs. Foreman at	$ 1.88
5	Hrs. Common Labor at	$ 2.03
	Hrs. Mason at	$
	Hrs. at	$
	Hrs. at	$
Syr.	Builders' Use of Water	$
Truck	at	$ 1.00
Comp. Dua	at	$ .10
	at	$
	at	$
	Total	$ 11.02

Labor and Material Report Sept 15 1924

Pipe Renewal 77 Winter Ave

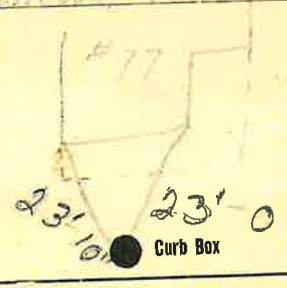

6 Main

Elev. of Main at tap 4½

Gate at

Gate at

Curb Box