Labor and Materials

Copper / Lead } Connection ..... $

Curb { Cock / Valve / T. S. & V. } ..... in ..... $

Service Box Old returned { Short 3½ x 4½ / Long 4½ x 5½ / Buff. or Rdway } ..... $

..... Ft. ..... in. { Copper / Galv Iron / Cast Iron } Pipe at ..... $

Nipples ..... in. at ..... $

Bushings ..... to ..... in. at ..... $

Red'g / Inc'g } Couplings ..... to ..... in. at ..... $

Union ..... in. at ..... $

Meter ..... in. at ..... $

Lead Joints at ..... $

Leadite Joints at ..... $

Hrs. Foreman at ..... $

Hrs. Chauffeur at ..... $

Hrs. Tapper at ..... $

Hrs. Labor at ..... $

Hrs. Labor at ..... $

Hrs. Compressor at ..... $

Compensation Ins. ..... $

Trucking ..... $

Builders Use of Water ..... $

..... $

..... $

..... $

..... $

$

Montcalm St. / Pl. / Ave. No. 88

Name of Owner

Labor and Mat'l. Report 7-2-21 19

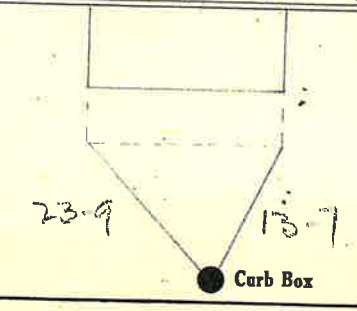

..... Main

Elev. of Main at tap ....

Gate at ●

● Gate at

● Curb Box

Tax ID # 309.7-12-14