## LABOR AND MATERIALS

| | | |
|---|---|---|
| 1 | Copper Lead } Connection 3/4 | $ 1.80 |
| 1 | Curb { Cock Valve T. S. & V. } 3/4 in. | $ 1.96 |
| 1 | Service Box Old returned { Short 3⅛x4⅛ Long 4⅛x5⅛ Buff or Rdway } Same Box | $ — |
| 32 | Ft. 3/4 in. { Copper Galv Iron Cast Iron } Pipe at 19 | $ 6.08 |
| | Nipples in. at | $ |
| | Bushings to in. at | $ |
| | Red'g Inc'g } Couplings to in. at | $ |
| | Union in. at | $ |
| | Meter in. at | $ |
| | Lead Joints at | $ |
| | Leadite Joints at | $ |
| | Hrs. Foreman at | $ |
| 12 | Hrs. Chauffeur at | $ 8.25 |
| | Hrs. Tapper at | $ |
| | Hrs. Labor at | $ |
| | Hrs. Labor at | $ |
| | Hrs. Compressor at | $ |
| | Compensation Ins. 2.669 | $ .77 |
| | Trucking | $ — |
| | Builders Use of Water | $ 9.75 |
| | | $ |
| | | $ |
| | | $ |
| | | $ |
| | | $ 29.06 |

IS-114

St.
Pl.
Ave. No. 38

Monument

Name of Owner

Goslin

Labor and Mat'l. Report July 18 19

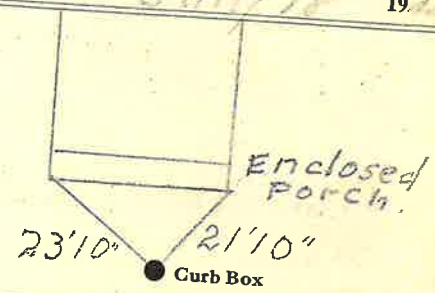


6 Main

Elev. of Main at tap 4½

Gate at ●

● Gate at

● Curb Box

Tax ID# 302.11-8-2