Labor and Materials

1	~~Lead~~ Connection Brass ¾	$
1	Curb Cock ¾	$
1	Service Box Old returned { ~~Short 3½ x 4½~~ / Long 4½ x 5½ / Buffalo	$
28	Ft. in. ~~G.I.~~ Pipe at Cop	$
	Nipples in. at	$
1	Bushings ½ to ¾ in. at	$
1	~~Red'g~~ Coup ¾ to in. at	$
	Inc'g Coup to in. at	$
	Union in. at	$
	Meter in. at	$
	Cu. Yds. Br. Stone at	$
	Cu. Yds. Sand at	$
	Bags Cement at	$
	Paving Brick { Mack / Red / Asphalt } at	$
7	Hrs. Foreman at	$
17	Hrs. Common Labor at	$
	Hrs. Mason at	$
	Hrs. at	$
	Hrs. at	$
	Builders' Use of Water	$
	at	$
	at	$
	at	$
	at	$
	Total	$ 23.18

Labor and Material Report

15

Aug 19 19 45

9 Morgan Ave

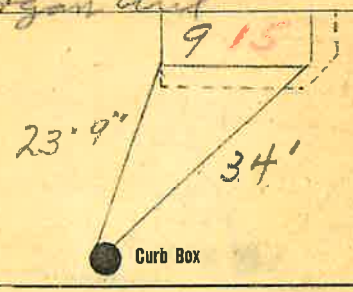

12" Main

Elev. of Main at tap 4'

Gate at ● ● Gate at

● Curb Box

Tax ID # 303.17-1-14