LABOR AND MATERIALS

1 Copper / ~~Lead~~ } Connection 3/4 ..... $

1 Curb } Cock / Valve / ~~T. S. & V.~~ } 3/4 in. ..... $

1 Service box Old returned } Short 3½ x 4½ / ~~Long 4½ x 5½~~ / ~~Buff or Rdway~~ } ..... $

9 Ft. 3/4 in. } Copper / ~~C. I.~~ / ~~C. D~~ } Pipe at ..... $

..... Nipples ..... in. at ..... $

..... Bushings ..... to ..... in. at ..... $

..... Red'g / Inc'g } Coupl'gs ..... to ..... in. at ..... $

..... Union ..... in. at ..... $

..... Meter ..... in. at ..... $

..... Lead Joints at ..... $

..... Compound Joints at ..... $

..... Maintenance Foreman ..... $

..... Hrs. Water Maint. Man—1 at ..... $

..... Hrs. Water Maint. Man—2 at ..... $

..... Hrs. Garage Foreman ..... at ..... $

..... Hrs. Labor— ..... at ..... $

..... Hrs. Compressor at ..... $

..... Compensation Ins. at $ ..... per C ..... $

..... Trucking ..... $

..... Pav't Patch ..... $

..... $

~~Tap By Gifford~~ ..... $

..... $

..... O'head ..... $

..... $

Morgan ~~St.~~ ~~Pl.~~ Ave. No. 24

Name of Owner

Labor and Mat'l. Report Dec 19 1966

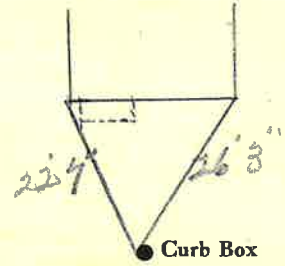

12" Main

Elev. of Main at tap 4'

Gate at ● ● Gate at

TAX ID # 303.13-23-27

● Curb Box

Old Tap. Dug up Mar 30-61

LSM—5C—2-5 56