Labor and Materials

1	Copper / ~~Lead~~	Connection 3/4	$ 1.23
1	Curb — Cock / Valve / ~~T. S. & V.~~	3/4 in	$ 1.68
1	Service Box — Old returned — Short 3½ x 4½ / ~~Long 4½ x 5½~~ / ~~Buff. or Rdway~~		$ 1.75
8	Ft. 3/4 in. — Copper / Galv Iron / Cast Iron	Pipe at .15	$ 1.20
	Nipples in. at		$
	Bushings to in. at		$
	Red'g / Inc'g — Couplings to in. at		$
	Union in. at		$
	Meter in. at		$
	Lead Joints at		$
	Leadite Joints at		$
	Hrs. Foreman at		$
3	Hrs. Chauffeur at 62½		$ 1.87
7/4	Hrs. Tapper at 5		$ 4.38
7	Hrs. Labor at 45		$ 3.15
	Hrs. Labor at		$
	Hrs. Compressor at		$
	Compensation Ins.		$ .29
	Trucking		$ 1.00
	Builders Use of Water		$
	Taylor Hose 2"		$
	Patch		$ 5.00
			$
			$
			$21.55

3 7 - 1938

St. Pl. Ave. Mercer Pl. No. 8

Name of Owner

Hoey

Labor and Mat'l. Report June 27 19 38

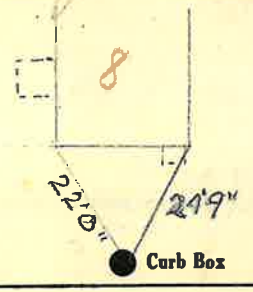

12 Main — Elev. of Main at tap 5½

Gate at • — • Gate at

• Curb Box

Tax ID # 303.13-23-18

old shut off