LABOR AND MATERIALS

1 Copper / ~~Lead~~	Connection 3/4	$ 1.31
1 Curb	Cock / ~~Valve~~ / ~~T. S. & V.~~ 3/4 in.	$ 1.75
1 Service Box Old returned	Short 3½x4½ / Long 4½x5½ / Buff. or Rdway	$ 1.60
25 Ft. 3/4 in.	Copper / ~~Galv. Iron~~ / ~~Cast Iron~~ Pipe at 16	$ 5.04
____ Nipples ____ in. at		$
____ Bushings ____ to ____ in. at		$
____ Red'g / Inc'g Couplings ____ to ____ in. at		$
____ Union ____ in. at		$
____ Meter ____ in. at		$
____ Lead Joints at		$
____ Leadite Joints at		$
____ Hrs. Foreman at		$
10 Hrs. Chauffeur at	62½	$ 1.25
2 Hrs. Tapper at	"	$ 1.25
18 Hrs. Labor at	45	$ 8.10
____ Hrs. Labor at		$
____ Hrs. Compressor at		$
____ Compensation Ins.		$ .48
____ Trucking		$ 1.—
____ Builders Use of Water	Patch	$ 5.—
Tapping Miller		$
		$
		$
		$
		$ 31.78

2 4 -- 1940

St. Pl. Ave. Marlais No. 25-

Name of Owner

Scales

Labor and Mat'l. Report May 23 1940

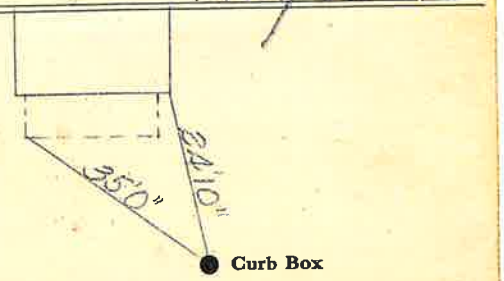

6 Main

Elev. of Main at tap 5'4

Gate at ●

● Gate at

● Curb Box

old shut off