LABOR AND MATERIALS

1	Copper / ~~Lead~~ Connection 3/4	$ 2.94
1	Curb { Cock / ~~Valve~~ / ~~T. S. & V.~~ } 3/4 in.	$ 3.71
1	Service box { Short 3½X4½ / Long ~~4½X5½~~ / ~~Buff or Rdway~~ } Old returned	$ 5.90
25	Ft. 3/4 in. { Copper / ~~G. I.~~ / ~~C. I.~~ } Pipe at 30	$ 7.50
	Nipples ... in. at	$
	Bushings ... to ... in. at	$
	Red'g / Inc'g Coupl'gs ... to ... in. at	$
	Union ... in. at	$
	Meter ... in. at	$
	Lead Joints at	$
	Compound Joints at	$
.5	Hrs. Water Maint. Man—1 at	$
5	Hrs. Water Maint. Man—2 at 91	$ 4.55
12	Hrs. Labor— ... at 80	$ 9.60
	Hrs. Labor— ... at	$
	Hrs. Compressor at	$
	Compensation Ins. at $ ... per C	$ 31
	Trucking	$ 1.00
	Pav't Patch	$ 14.20
	Tap by Mossmann	$
		$
		$
	O'head	$
		$ 49.71

94

Murdock St. Pl. Ave. No. 20

Name of Owner

Sauter

Labor and Mat'l. Report July 22 1948

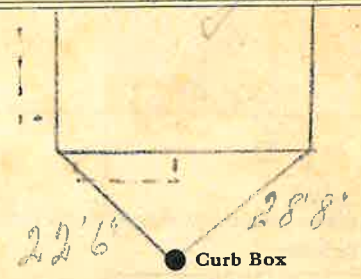

1 Main

Elev. of Main at tap 5

Gate at ●

● Gate at

● Curb Box

TAX ID # 302.12-21-7

LSM-5C 5 15-48