LABOR AND MATERIALS

1	Copper / Lead } Connection	3/4	$ 1.80
1	Curb { Cock / Valve / T. S. & V. }	3/4 in.	$ 1.96
1	Service Box / Old returned { Short 3½x4½ / Long 4½x5½ / Buff or Rdway }		$ 1.82
9	Ft. 3/4 in. { Copper / Galv Iron / Cast Iron } Pipe at 19		$ 1.71
	Nipples ... in. at		$
	Bushings ... to ... in. at		$
	Red'g / Inc'g } Couplings ... to ... in. at		$
	Union ... in. at		$
	Meter ... in. at		$
	Lead Joints at		$
	Leadite Joints at		$
	Hrs. Foreman at		$
7	Hrs. Chauffeur at	68¾	$ 4.81
	Hrs. Tapper at		$
6	Hrs. Labor at	60	$ 3.60
	Hrs. Labor at		$
1	Hrs. Compressor at	87½	$ 88
	Compensation Ins.		$ 22
	Trucking		$ 1 —
	Builders Use of Water		$ 5.85
	tap by Warsinski		$
			$
			$
			$
			$ 23.65

18 | 44

St. / Pl. / Ave. No. 21

Murdock

Name of Owner

Pinkerton

Labor and Mat'l. Report Aug 22 19

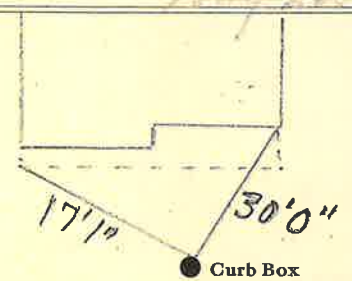

4 Main

Elev. of Main at tap 6

Gate at ●

● Gate at

● Curb Box

TAX ID# 302.12-22-5