LABOR AND MATERIALS

1	Copper Lead	Connection 3/4	$ 2.80
1	Curb — Clock Valve — T. S. & V.	3/4 in.	$ 3.60
1	Service box Old returned	Short 3½X4½ Long 4½X5½ Buff or Rdway	$ 5.80
8	Ft. 3/4 in.	Copper Galv. Iron Cast Iron	Pipe at $ 2.80
	Nipples	in. at	$
	Bushings	to in. at	$
	Red'g Inc'g Couplings	to in. at	$
	Union	in. at	$
	Meter	in. at	$
	Lead Joints at		$
	Compound Joints at		$
2	Hrs. Foreman at		$ 2.07
1	Hrs. Chauffeur at		$ .91
	Hrs. Tapper at		$
13	Hrs. Labor at		$ 10.40
	Hrs. Labor at		$
	Hrs. Compressor at		$
	Compensation Ins.		$ .29
	Trucking		$ 1.00
	Builders Use of Water		$
	Tapp by Watsinski		$
			$
			$
			$
			$ 29.67

71-47

Murdock St. Pl. Ave. No. 29

Name of Owner

Lowery

Labor and Mat'l. Report July 30 1947

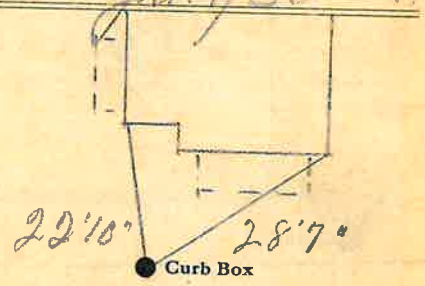

Mason ST.

4 Main

Elev. of Main at tap X

Gate at ● ● Gate at

● Curb Box

TAX ID# 302.12-22-1

L9M-5C-6-1-45 Tap on Mason St