LABOR AND MATERIALS

1	Copper ~~Lead~~ Connection 3/4	$ 1.23
1	Curb Cock ~~Valve~~ ~~T. S. & V.~~ 3/4 in.	$ 1.68
1	Service Box Old returned ~~Short 3½x4½~~ Long 4½x5½ ~~Buff. or Rdway~~	$ 1.54
28	Ft. 3/4 in. Copper ~~Galv Iron~~ ~~Cast Iron~~ Pipe at 17	$ 4.76
	Nipples ____ in. at	$
	Bushings ____ to ____ in. at	$
	Red'g / Inc'g Couplings ____ to ____ in. at	$
	Union ____ in. at	$
	Meter ____ in. at	$
	Lead Joints at	$
	Leadite Joints at	$
	Hrs. Foreman at	$
4	Hrs. Chauffeur at 62½	$ 2.50
9	Hrs. Tapper at "	$ 5.63
9	Hrs. Labor at 45	$ 4.05
	Hrs. Labor at	$
	Hrs. Compressor at	$
	Compensation Ins.	$ .37
	Trucking	$ 1.—
	Builders Use of Water Patch	$ 5.—
	Tap by Hessel	$
		$
		$
		$
		$ 27.76

8 1 - - 1939

St. 10
Pl.
Ave. No. 6

Murdock Ave

Name of Owner

McAllister

Labor and Mat'l. Report Oct 4 1939

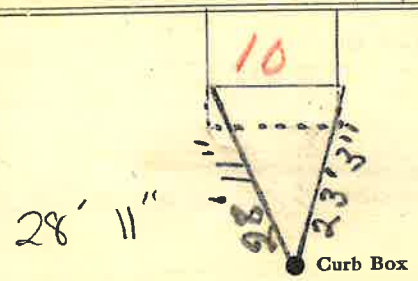

4 Main

Elev. of Main at tap 6

Gate at ●

● Gate at

28' to main

● Curb Box

TAX ID # 302.12-21-4

old Shut off