Labor and Materials

1	Copper ~~Lead~~ Connection	3/4	$ 1.46
1	Curb { Cock / ~~Valve~~ / T. S. & V. } in	3/4	$ 1.93
1	Service Box Old returned { Short 3½ x 4½ / ~~Long 4½ x 5½~~ / Buff. or Rdway }		$ 1.77
11	Ft. in. { Copper / ~~Galv. Iron~~ / ~~Cast Iron~~ } Pipe at	3/4	$ 2.42
	Nipples in. at		$
	Bushings to in. at		$
	Red'g Inc'g Couplings to in. at		$
	Union in. at		$
	Meter in. at		$
	Lead Joints at		$
	Leadite Joints at		$
	Hrs. Foreman at		$
4	Hrs. Chauffeur at		$ 2.50
	Hrs. Tapper at		$
9	Hrs. Labor at 45		$ 4.05
	Hrs. Labor at		$
	Hrs. Compressor at		$
	Compensation Ins.		$ .20
	Trucking		$ 1.00
	Builders Use of Water Patch		$ 5.00
			$
			$
			$
	Tap by [illegible]		$
			$ 20.33

11 2-1937

St. Pl. Ave. Murdock No. 13

Name of Owner

Glassbrook

Labor and Mat'l. Report Oct 22 1937

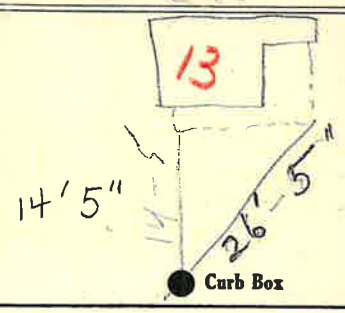

4" Main

Elev. of Main at tap [illegible]

Gate at • • Gate at

• Curb Box

old Shut off

TAX ID# 302.12-22-9

M