Labor and Materials

1	Copper ~~Lead~~ Connection ¾"	$ 1.50
1	Curb Cock ~~Valve~~ ~~T.S.&V.~~ ..... in ¾"	$ 1.70
1	Service Box Old returned Short 3½x4½ ~~Long 4½x5½~~ ~~Buff. or Ruwer~~	$ 1.44
10	Ft. ¾ in. Copper ~~Galv. Iron~~ ~~Cast Iron~~ Pipe at	$ 1.90
	Nipples .....in. at	$
	Bushings .....to .....in. at	$
	Red'g Inc'g Couplings.....to.....in.at	$
	Union.....in. at	$
	Meter.....in. at	$
	Lbs. Br. Stone at	$
	Lbs. Sand at	$
	Bags Cement at	$
	Paving Brick Mack Red Asphalt at	$
	Lead Joints at	$
	Leadite Joints at	$
3	Hrs. Foreman at 6 6.27	$ 1.88
16	Hrs. Common Labor at .45	$ 7.20
	Hrs. Common Labor at	$
	Hrs. Mason at	$
	Hrs. Masons Helper at	$
	Hrs. Compressor at	$
	Compensation Ins	$ 0.33
	Trucking	$ 1.-
	Builders Use of Water Post Patch	$ 5.-

Total $ 21.95

43

56 34 7

Labor and Material Report Aug 19

3 Nelson St

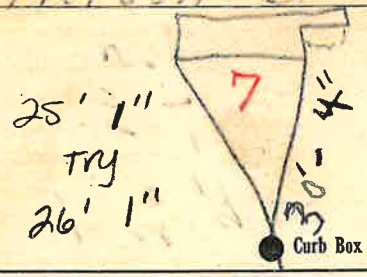

~~4~~ 6" Main

Elev. of Main at tap 5"

Gate at ● ● Gate at

● Curb Box

old Tap Shut off in

Tax ID# 302.20-11-21

Paid

1st